

# A NEW PERGOLA & FIREPLACE FOR THE

DESCRIPTION

# **MOONE RESIDENCE**

# 141 Canyon Court Napa, CA 94558

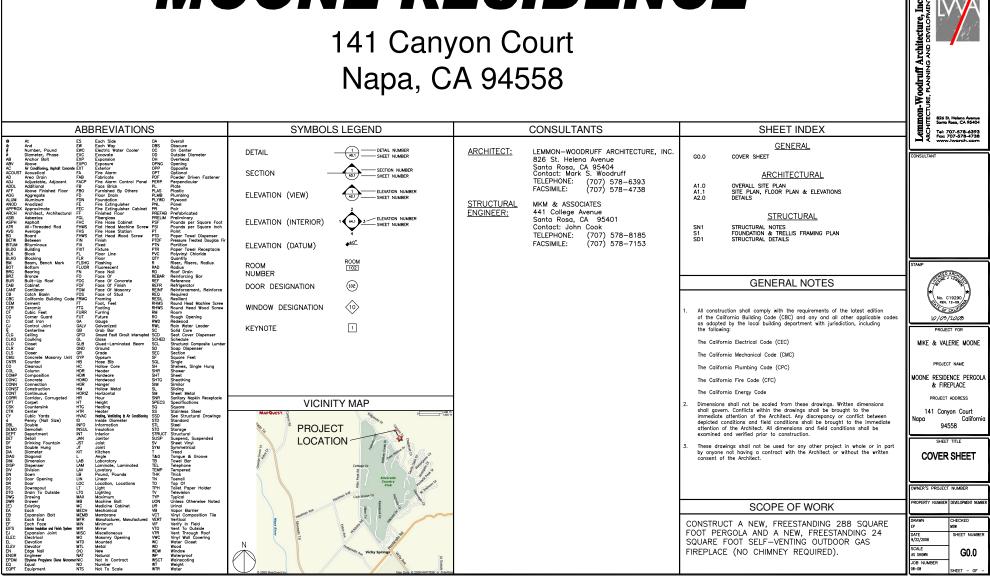

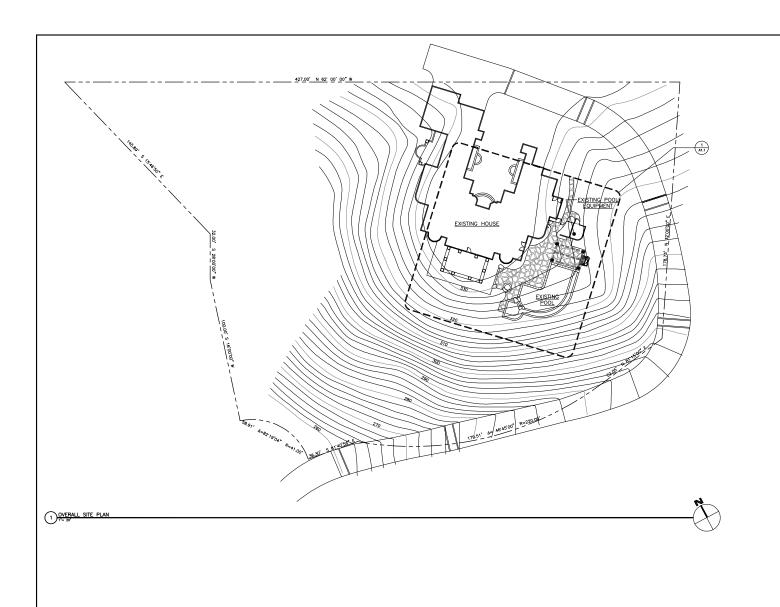

# SITE PLAN NOTES

ı	MARK	DATE	DESCRIPTION
ı			
ı			
Lemmon-Woodruff Architecture, Inc.
Architecture, Inc.
Architecture, Inc.
Architecture, Parking Avo Development
Architecture, Inc.
Architecture, In

10/03/2008

MIKE & VALERIE MOONE

PROJECT NAME

MOONE RESIDENCE PERGOLA & FIREPLACE


141 Canyon Court California

SHEET TITLE

OVERALL SITE PLAN

OWNER'S PROJECT NUMBER

ı	DRAWN EP	MSW
ı	DATE 9/22/2008	SHEET NUMBER
ı	SCALE AS SHOWN	A1.0
ı	JOB NUMBER 08-08	SHEET - OF -

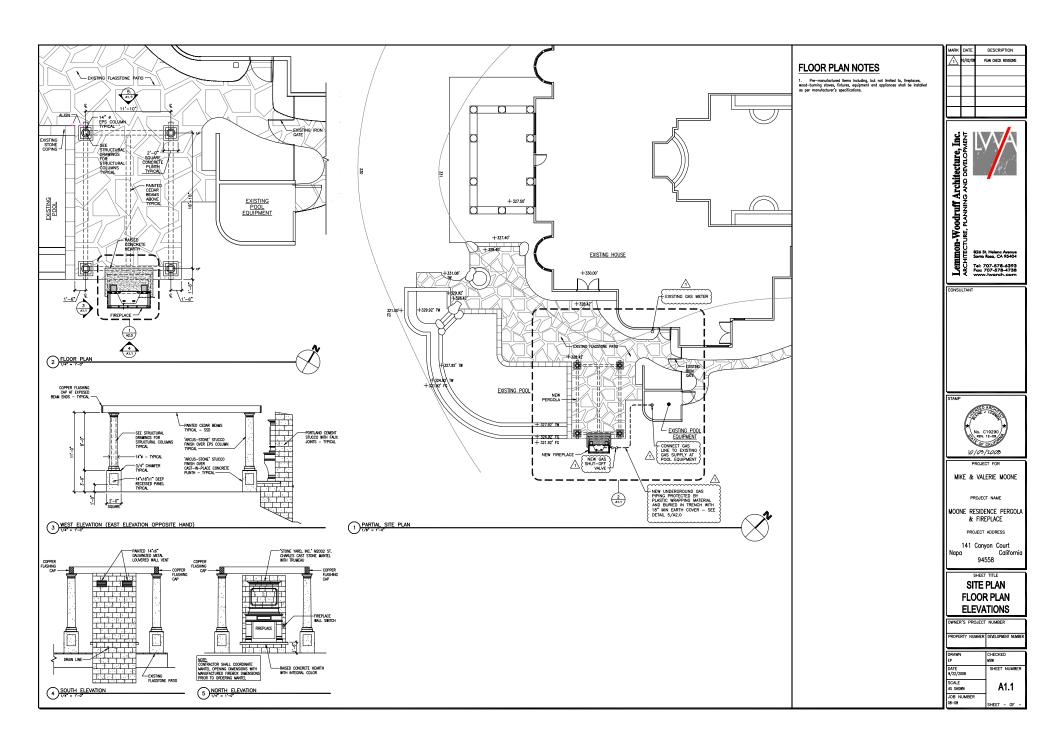



(see Field Wiring page 10).

be installed outdoors.

ALTERATION MAY VOID THE WARRANT CERTIFICATION AND LISTINGS OF THIS UNI

Electronic appliances are designed to operate. When Planning for the installation of the on natural gas or opcome. An electronic intermittent pilot ignition system provides acts, efficient operation. A Dattery park act, efficient operation. A Dattery park act required to operate these units.

Additional space below the fireplace will be also active to park a decidence of the parks of the parks and interest on parks and the parks of the parks and interest on the parks of the parks o ranty. - three (3) bags of lave rock, envelope is

These appliances comply with National Safety Standards and are tested by form if set Labo-Standards and set tested by form if set Labo-statories (Report No. 116F-41-5) and listed the bottom of the drain pan before posit by CSA-4-96 in both USA and Canada, as the fireplace on its location (Figure 3).


The Installation must conform to local codes or in the absence of local codes, with the Absence of local codes, ASM 2223.18FPA 54. or the Mathral Size and Propane Installation Code, CSA 8149.1.


## CLEARANCES


Minimum clearance to combustibles for the fireplace is as follows; sides and back – 1/2' (13mm), combustible floor –0' (0mm), adjacent wall 6' (13zmm), ceiling –50' (127omm). Refer to Figure 4 on this page and Figure 18 on page 13 for more detail.


Note: Clearance behind the nailing flange to both fireplace models is 1/2" (13mm).

ides of the fireplace. Allow at least 4 feet or ne side of the fireplace.

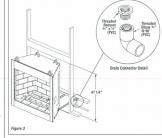

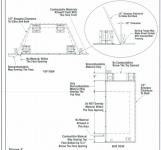

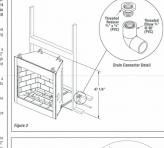

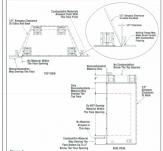

# TYPICAL INSTALLATION

NFI (5)

PACKAGING

tion when servicing controls. Wiring error can cause improper and dangerous opera tion. Verify proper operation after servicing


he U.S. by the National Fireplace Institute\* (NFI) as NFI Gas Specialists.


efer to Figure 10 for the wiring schemal

iwo brown wires are for the connection of to switch. These are labeled SW and SW. A bilated and red pair are for connection to the batte pack. These are labeled (+) and (-).

ox in an approprisate location within the lengit if the wiring provided. Feed all four wires hrough one of the lower inlets to the box connect the switch wires to the switch and the corresponding (+), (-) to the battery holder.

est the switch before closing the switch box refer to Figure 11). The igniter should spark o the pilot when the switch is on.

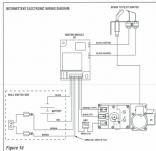

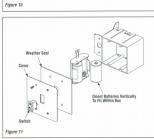

upply line. Flaure 12 illustrates two me

to aid in attaching the direct went appriance to the gas supply. The gas flex line can only be used where local codes permit. See Figure 12 for flex line description. The flex line is rated for both natural and propane gas. A manual sub-off valve is also provided with the flex line.

and remove the access cover (see Figure 13).


The control valves have a 3/8" (10 mm) NPT thread inlet port.


Secure all joints tightly using appropriate tools and sealing compounds (ensure propane resistant compounds are used in propane applications).


Turn on gas supply and test for gas leaks using a gas leak test solution (also referred to as bubble leak solution). Note: Using a soap water solution (50% dish soap, 50% water) is an effective leak test solution but it is no recommended, because the soap residue tha

A. Light the appliance (refer to the lighting instructions label in the control compartment or in the Homeowner's Care and Operation


B. Brush all joints and connections with th 8. Brush all joints and connections with the gas leak test solution to check for leaks. If bubbles are formed, or gas odor is detected, turn the gas control knob to the "OFF" post-tion. Either tighten or refasten the leaking connection and retest as described above.

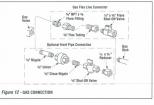


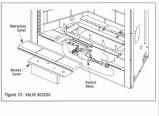

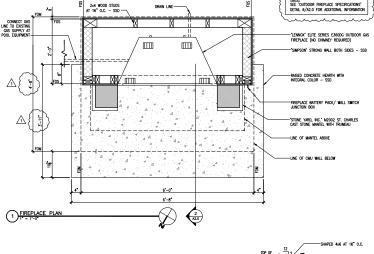

5'-9

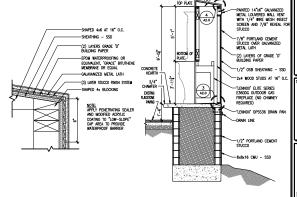

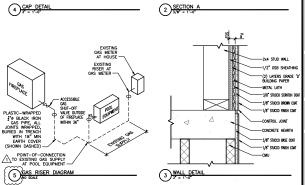



Lemmon-Woodruff Architecture, Inc. architecture, Pacharchitecture, Planning and Development

DESCRIPTION

PLAN CHECK REVISIONS

826 St. Helena Avenue Santo Rosa, CA 95404

Tel: 707-578-6393 Fax: 707-578-4738

MIKE & VALERIE MOONE

PROJECT NAME

MOONE RESIDENCE PERGOLA & FIREPLACE

141 Canyon Court Napa California 94558

SHEET TITLE

DETAILS

WNER'S PROJECT NUMBER OPERTY NUMBER DEVELOPMENT NUMBER

SCALE A2.0 AS SHOWN JOB NUMBER

(6) LENNOX' ELITE SERIES OUTDOOR FIREPLACE SPECIFICATIONS